


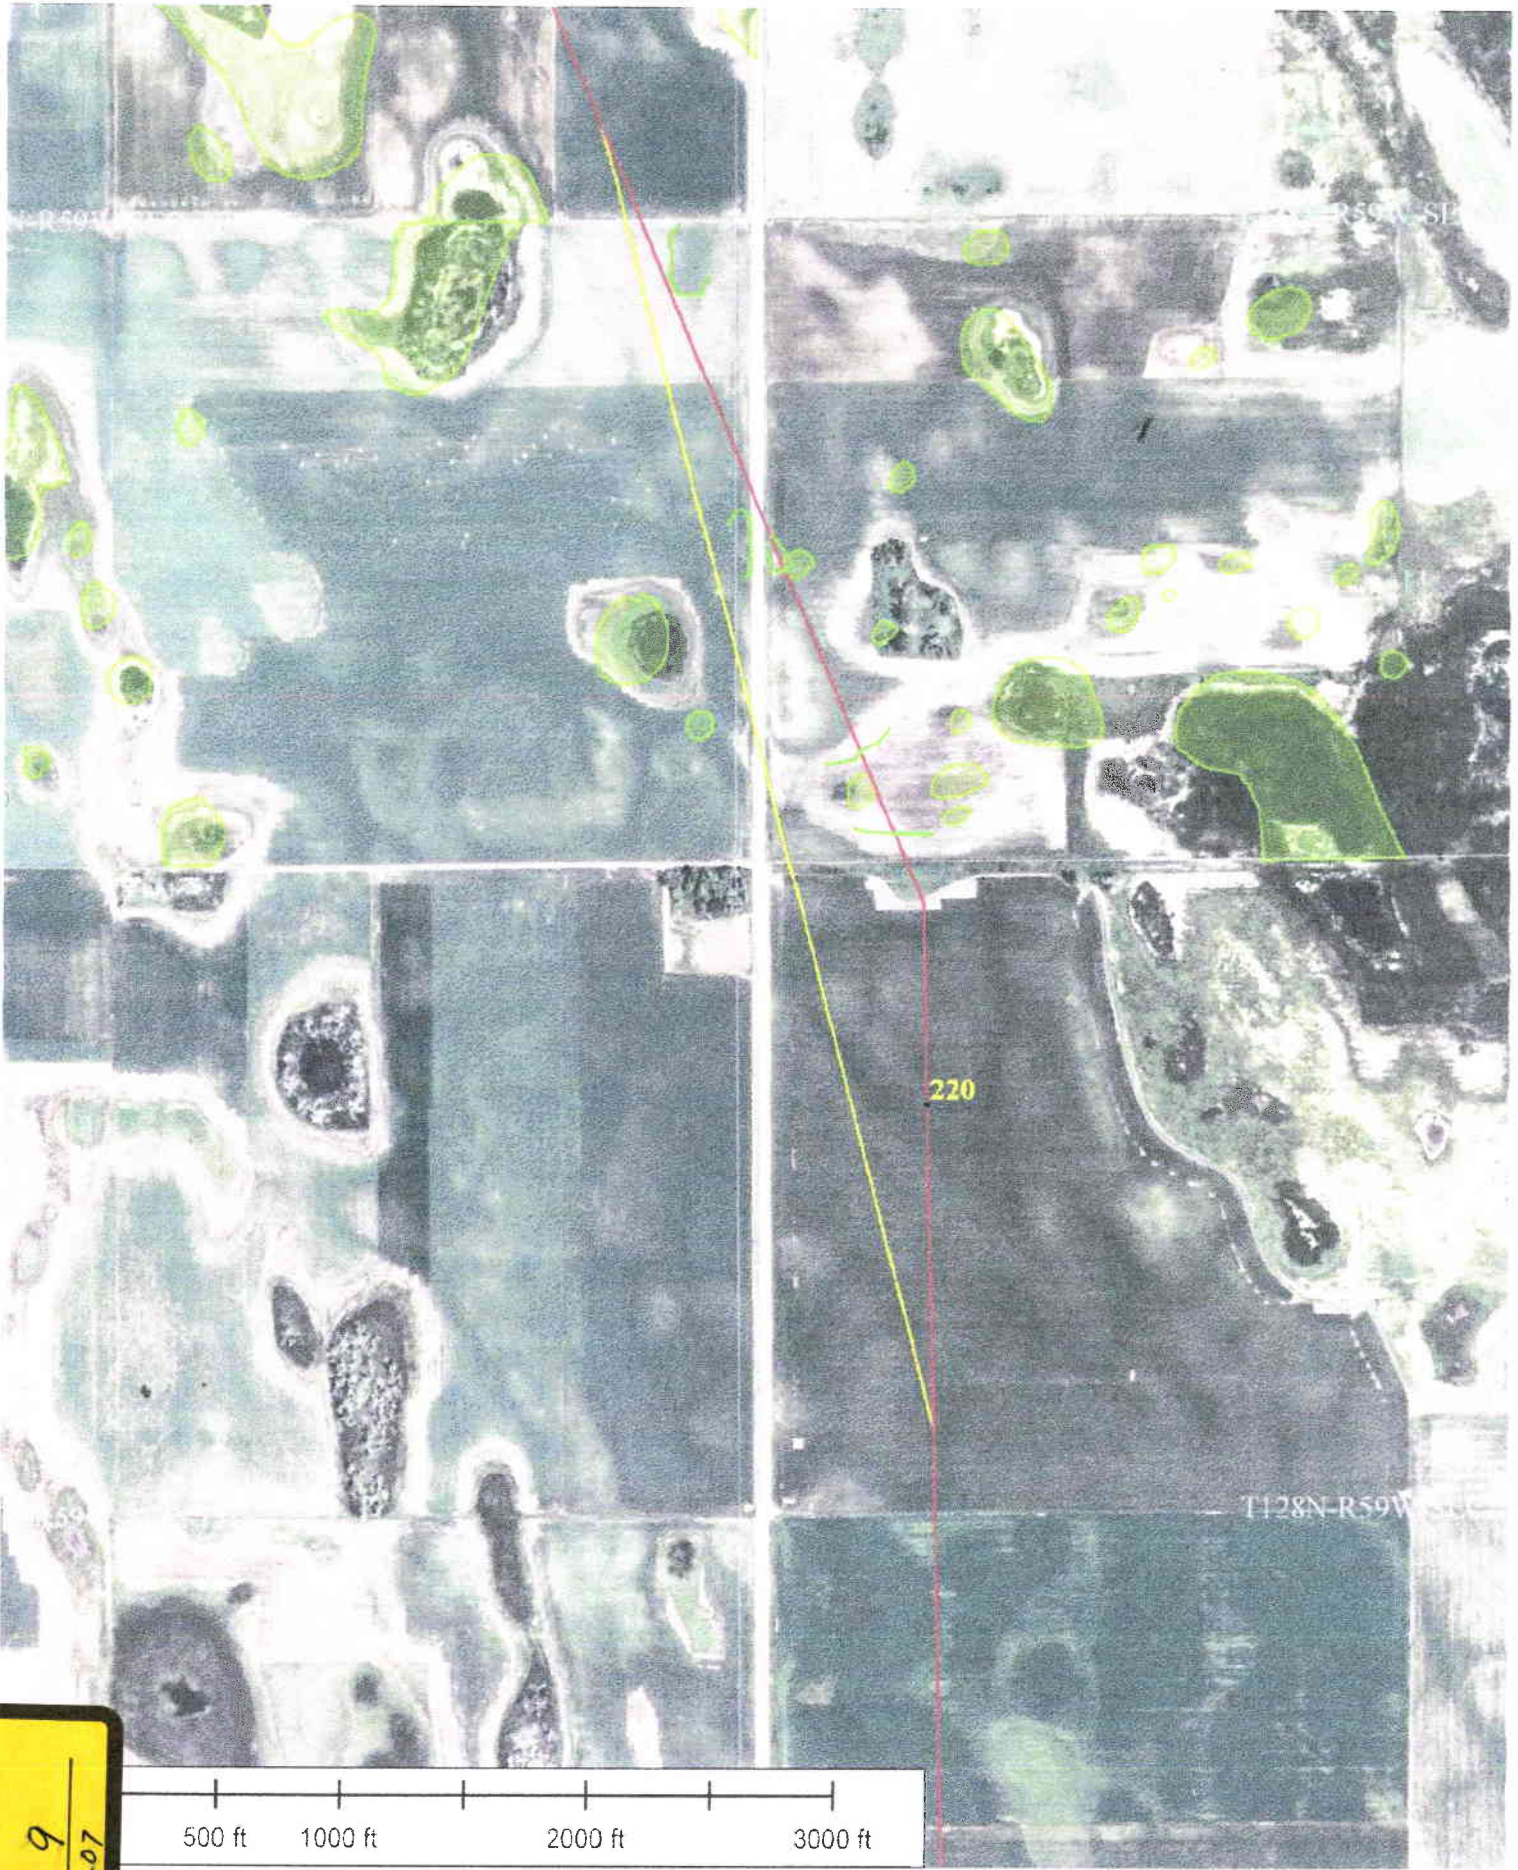

EXHIBIT

TC 9

12-3-07


lablles

500 ft 1000 ft 2000 ft 3000 ft

Marshall County, SD MP 219.2-220.2 New Landowners 0 Additional Length -75


TC-9

NRCS Reroute 229 - SD 10221.5-10224.2-S

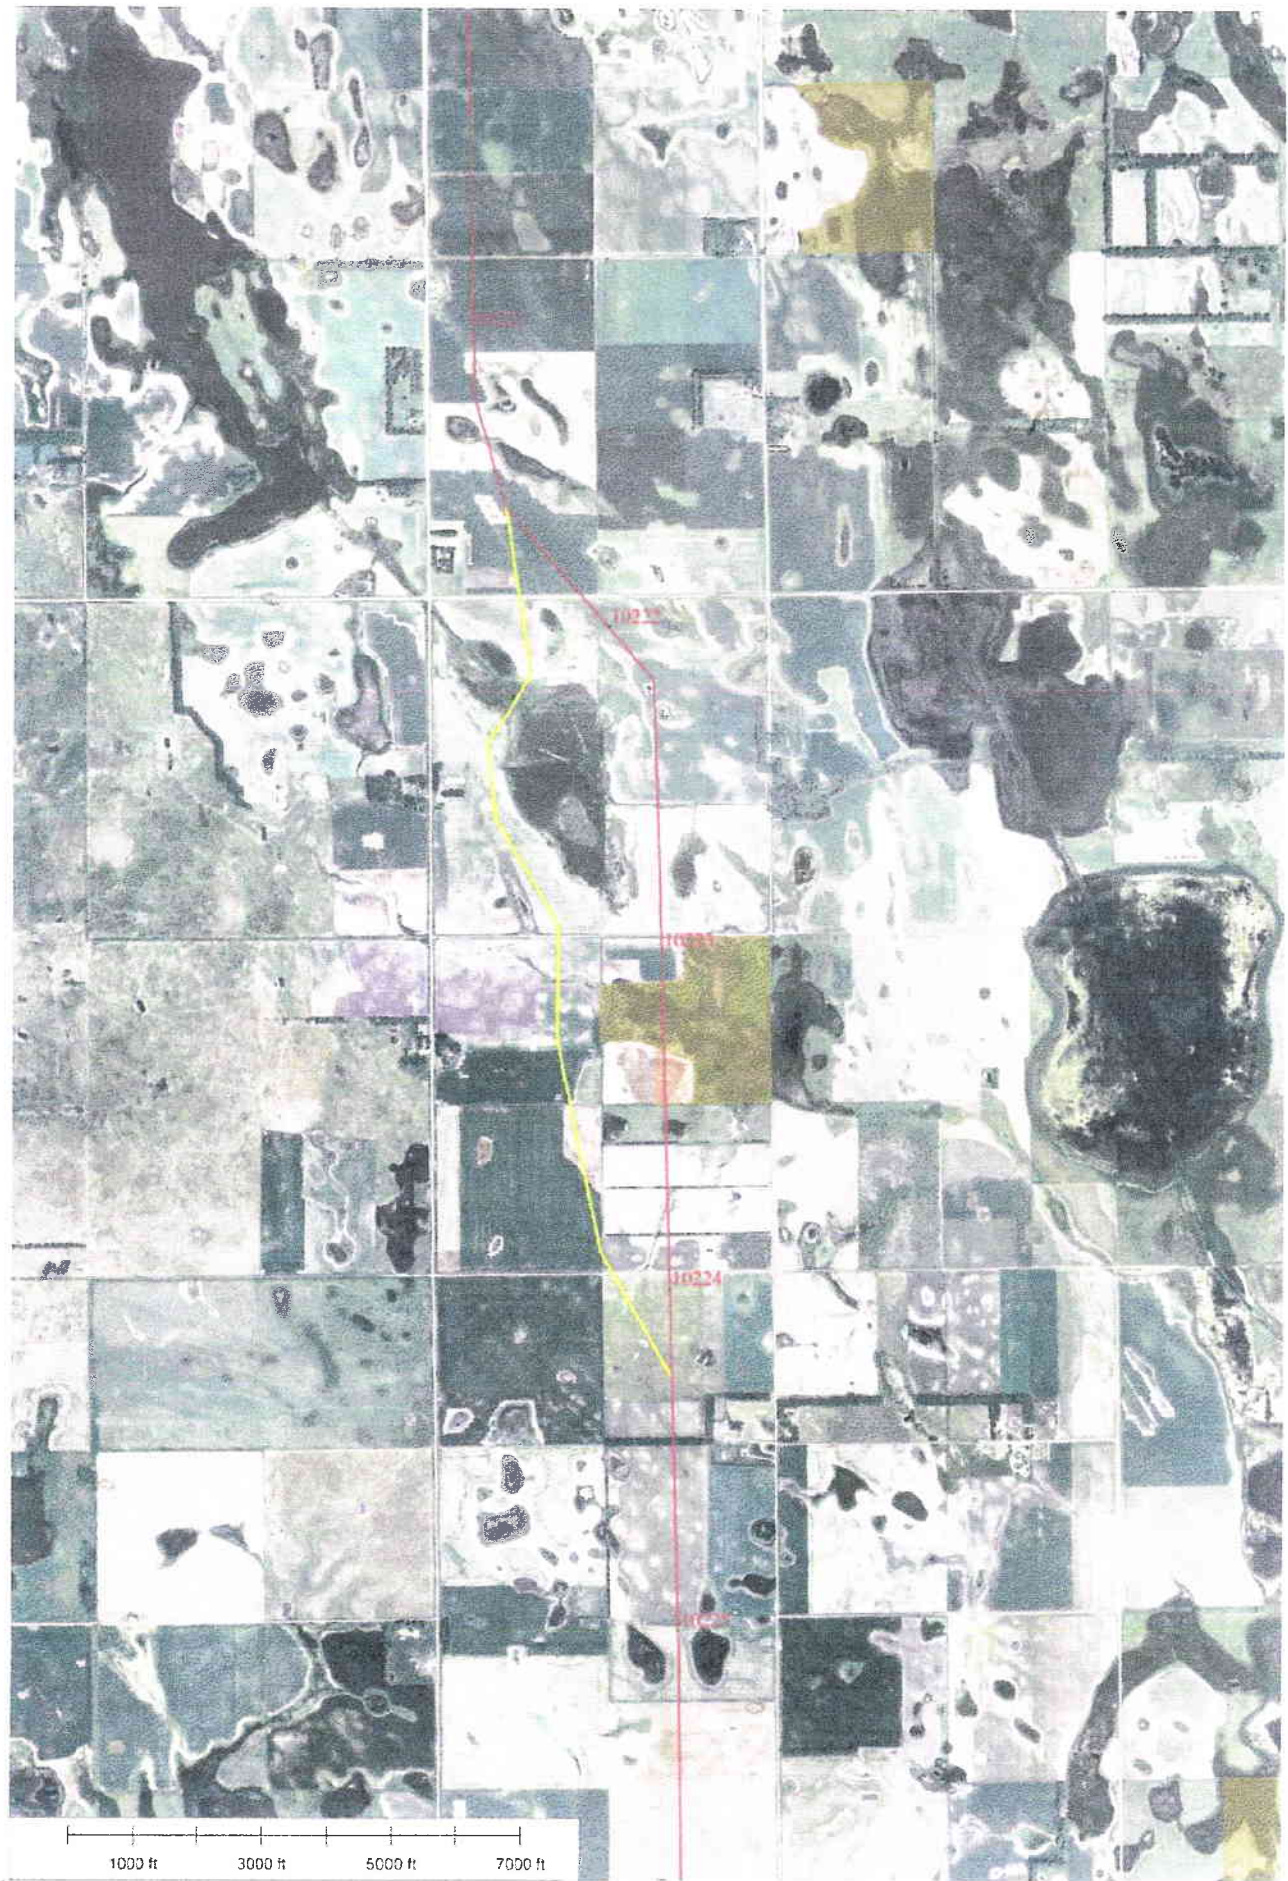


Marshall Co, SD Yellow Line Route Variation Red Line Keystone Centerline

Route Variation 232-SD-10226.3-10228.1-S

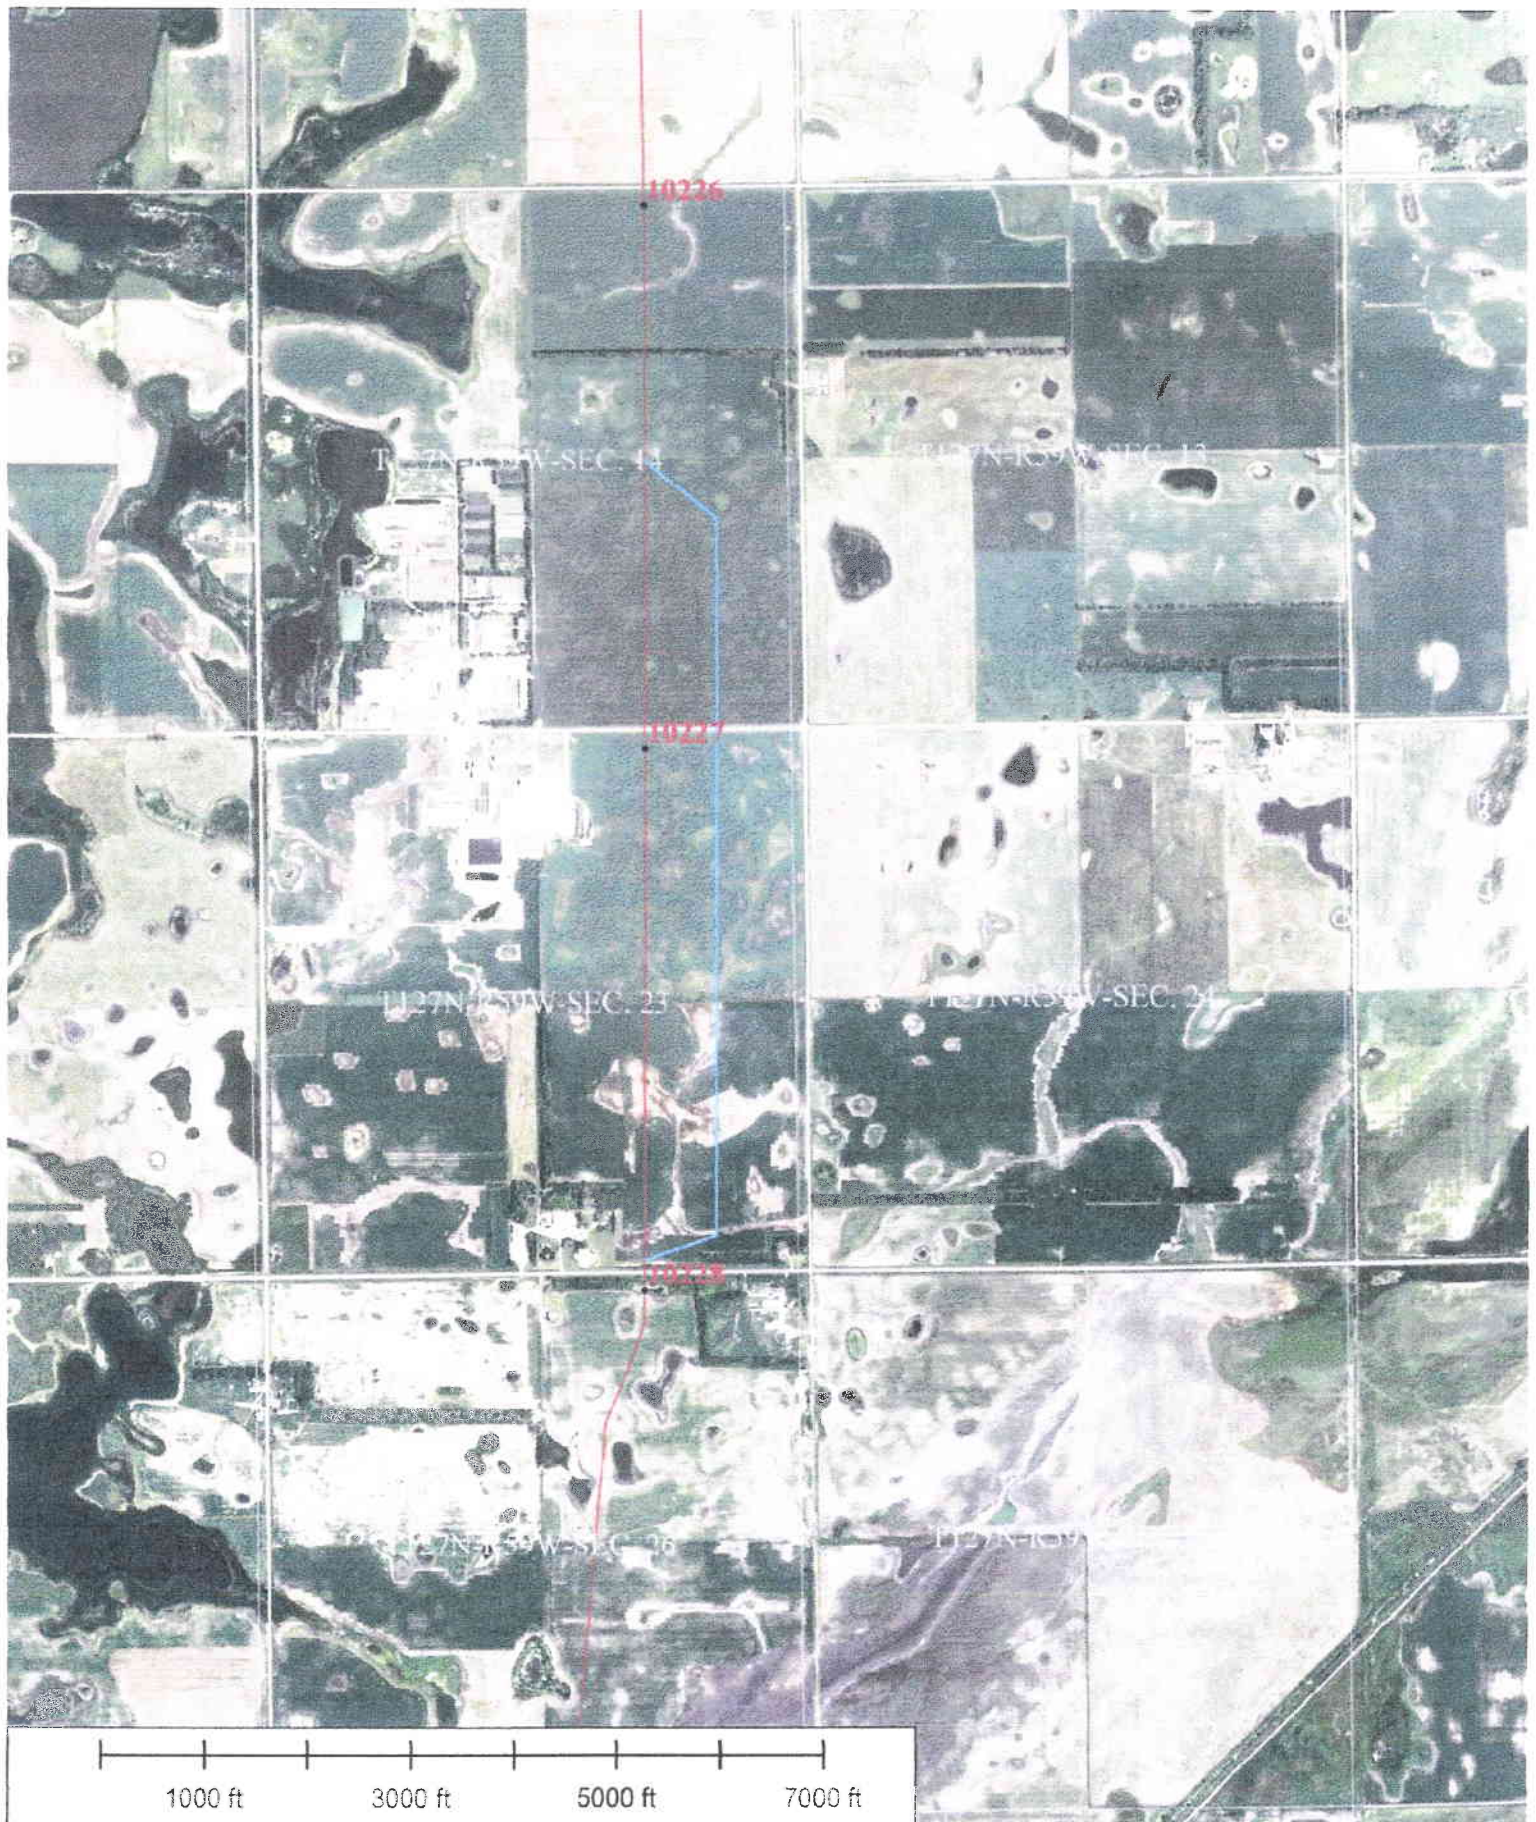


This is the revised Route Variation after meeting with Hutturian Brethren

Re-Route MP 230.6 to MP 231.6, for Landowners Bill and Phyllis Tisher

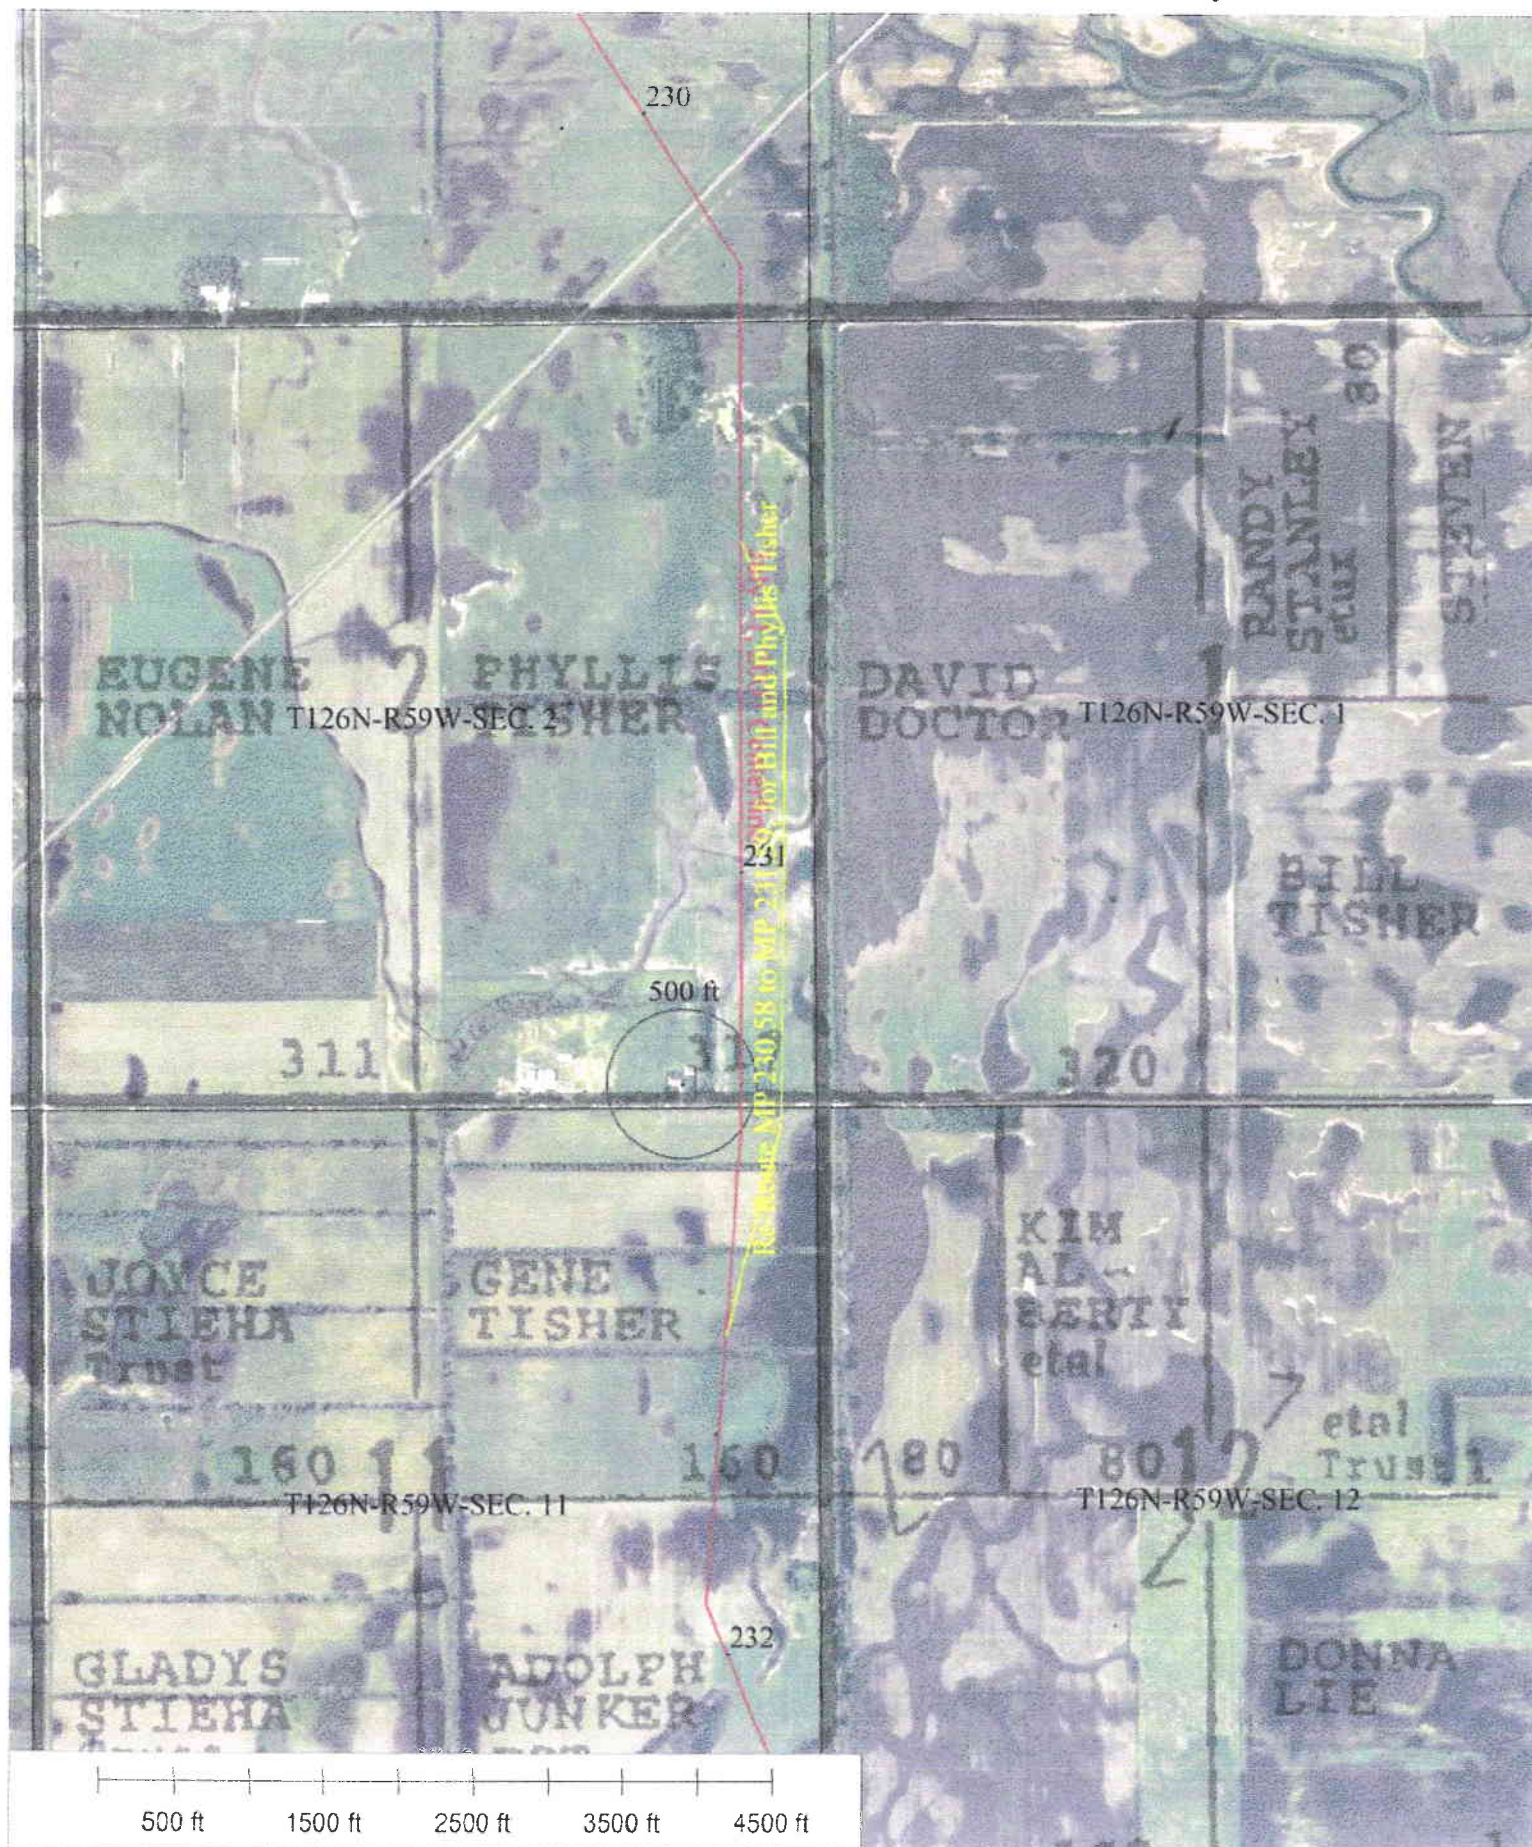



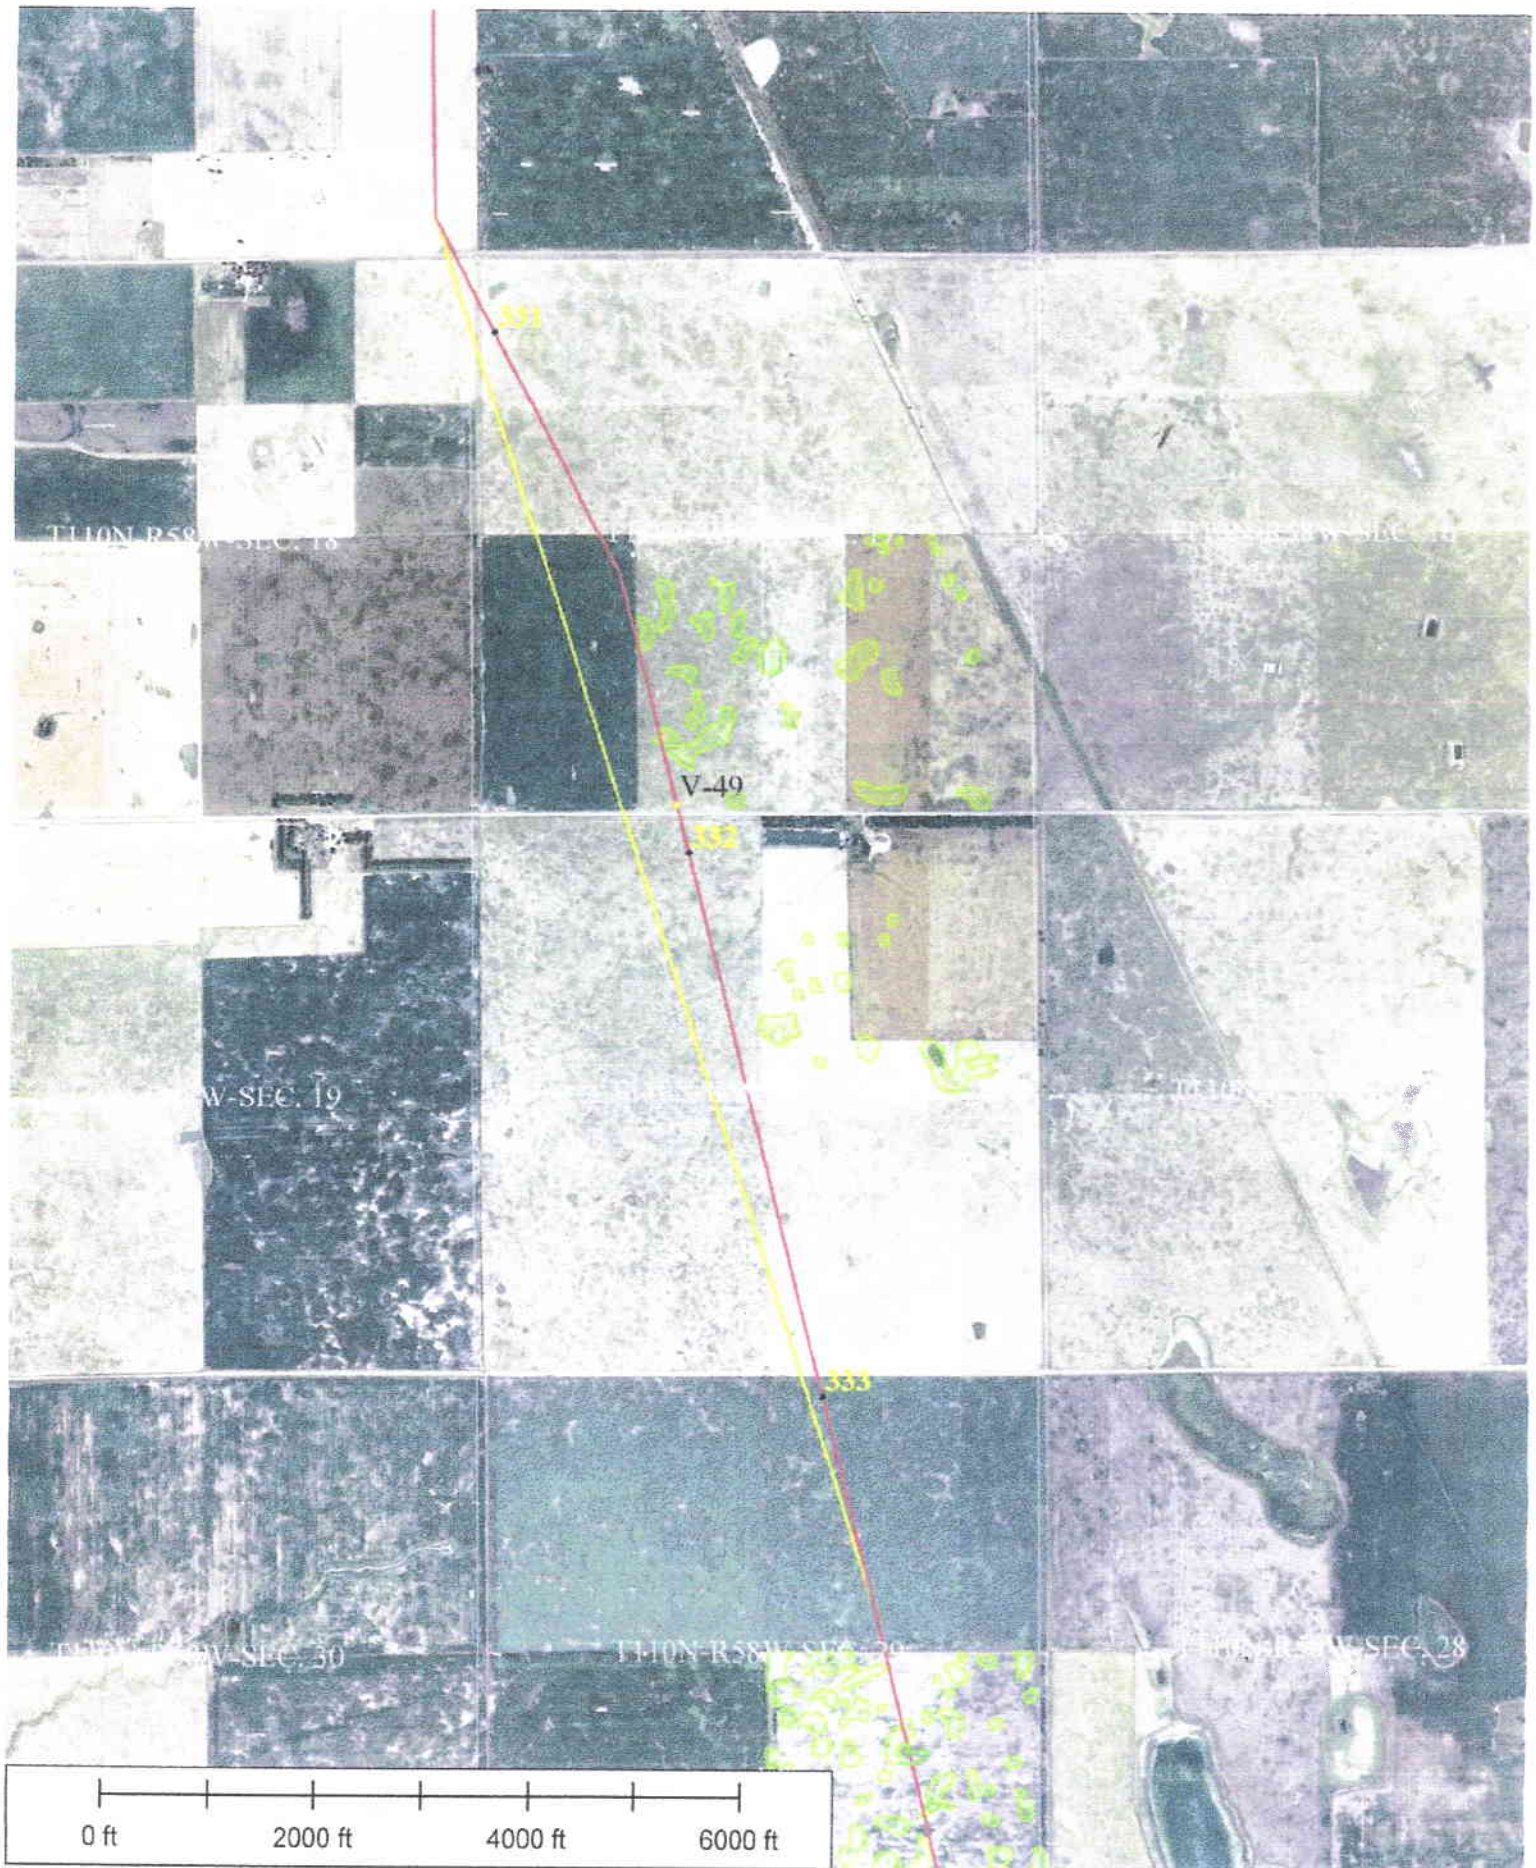



Route Variation 239




Minor County, SD

MP 355.8 - 357.7

New Landowner 0

Additional Length +50'

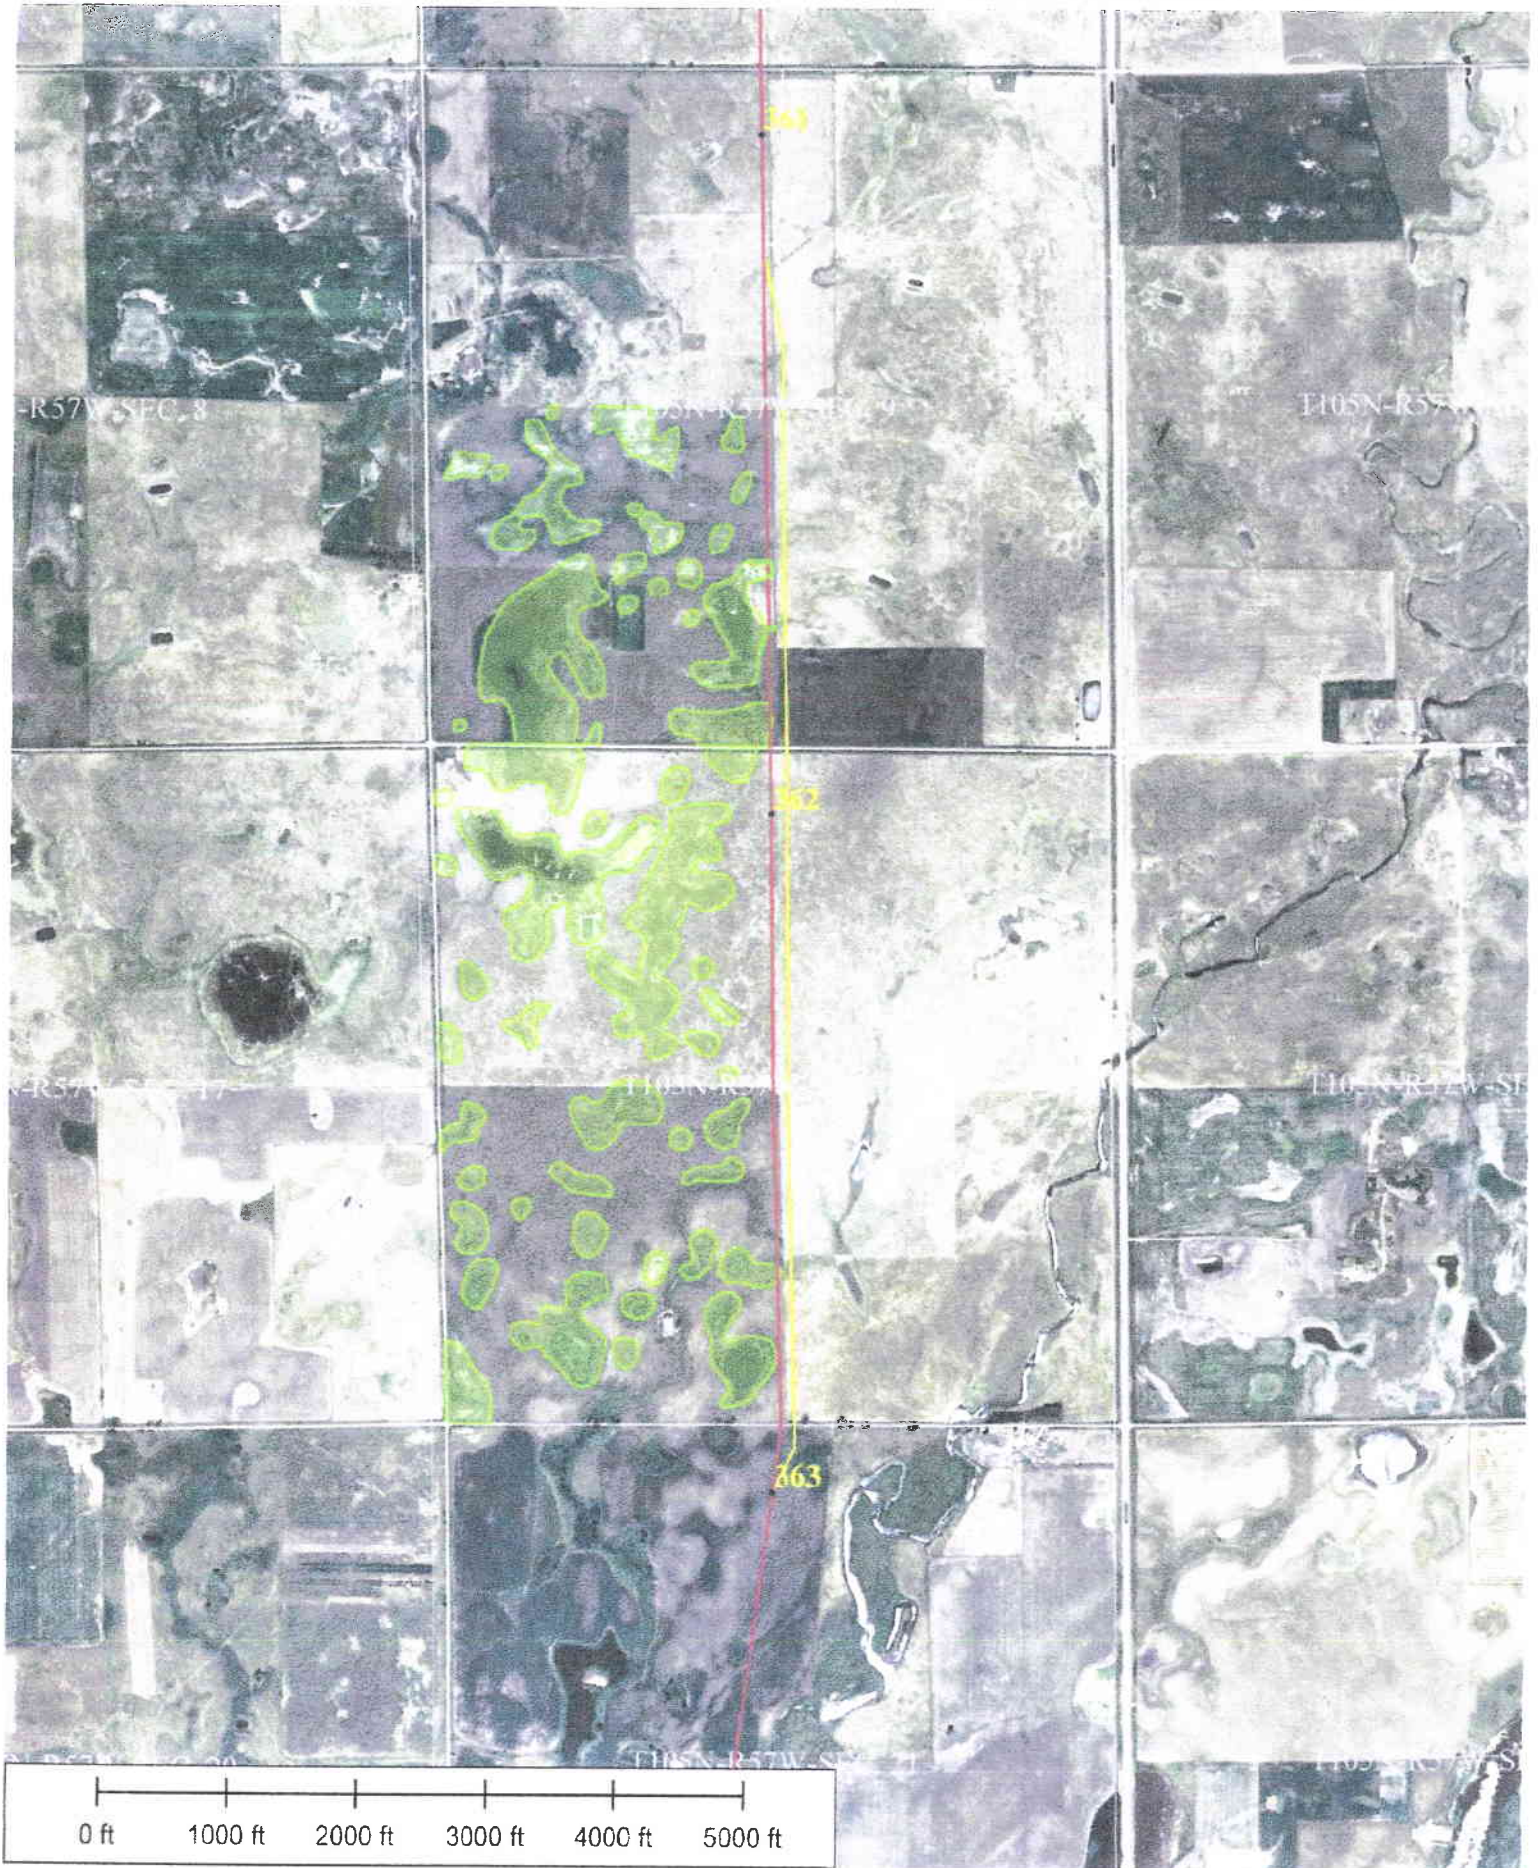

Minor County, SD


MP 361.2 - 363.0

New Landowners 3

Additional Length +50'

Route Variation:

242-SD-392.3-392.6-I

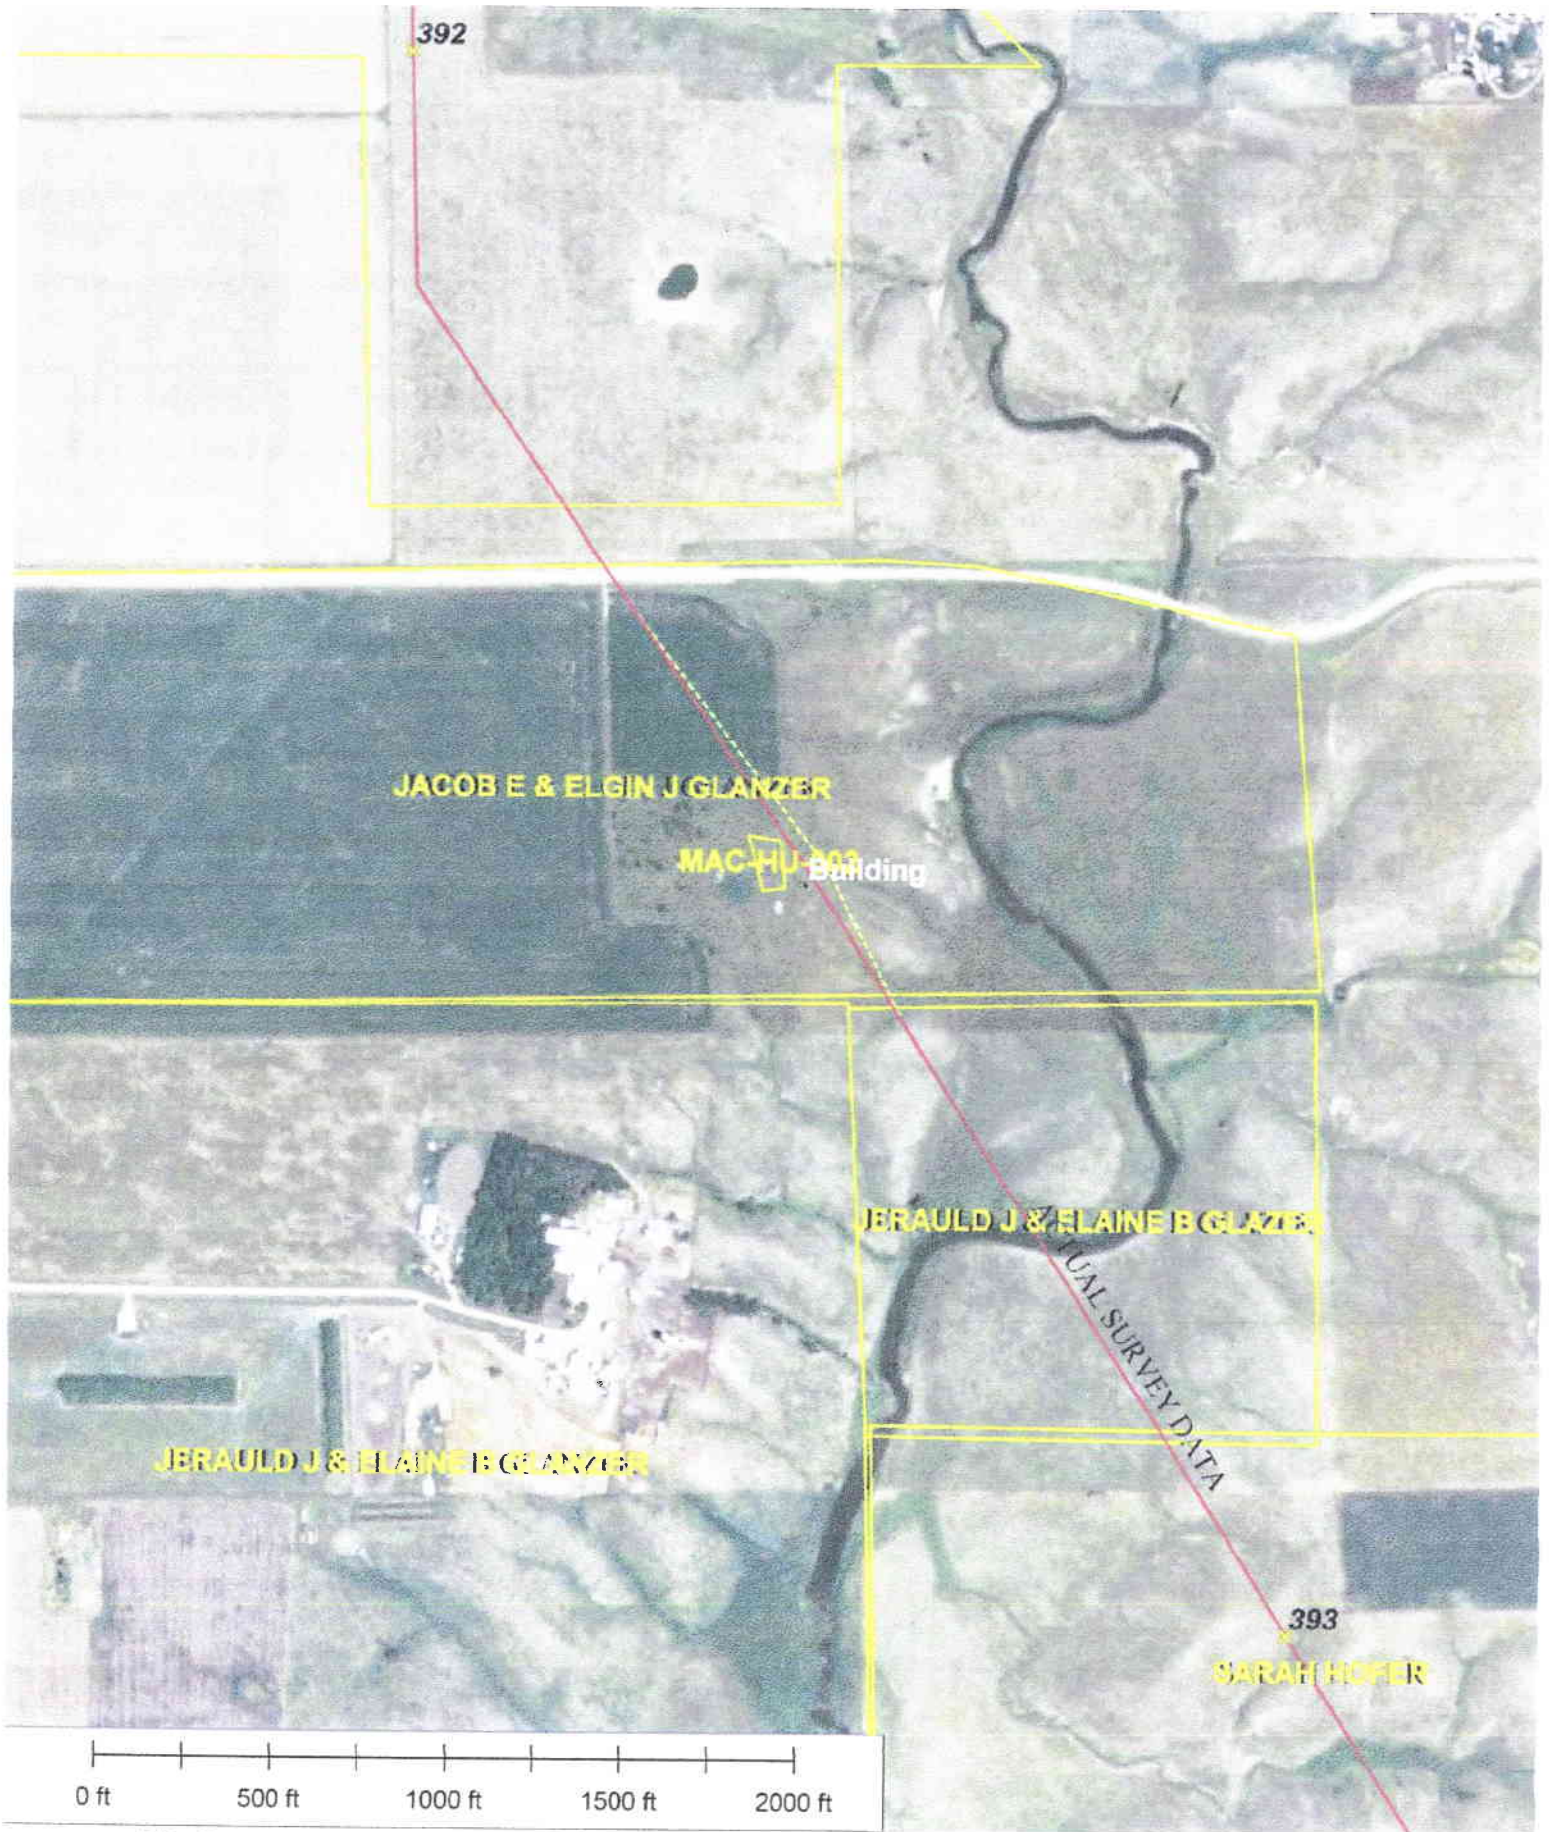


242-SD-392.3-392.6-I

Additional Length: 5ft

Max. Deviation: 49ft

Schultz reroute MP. 410.36 - MP. 412.11

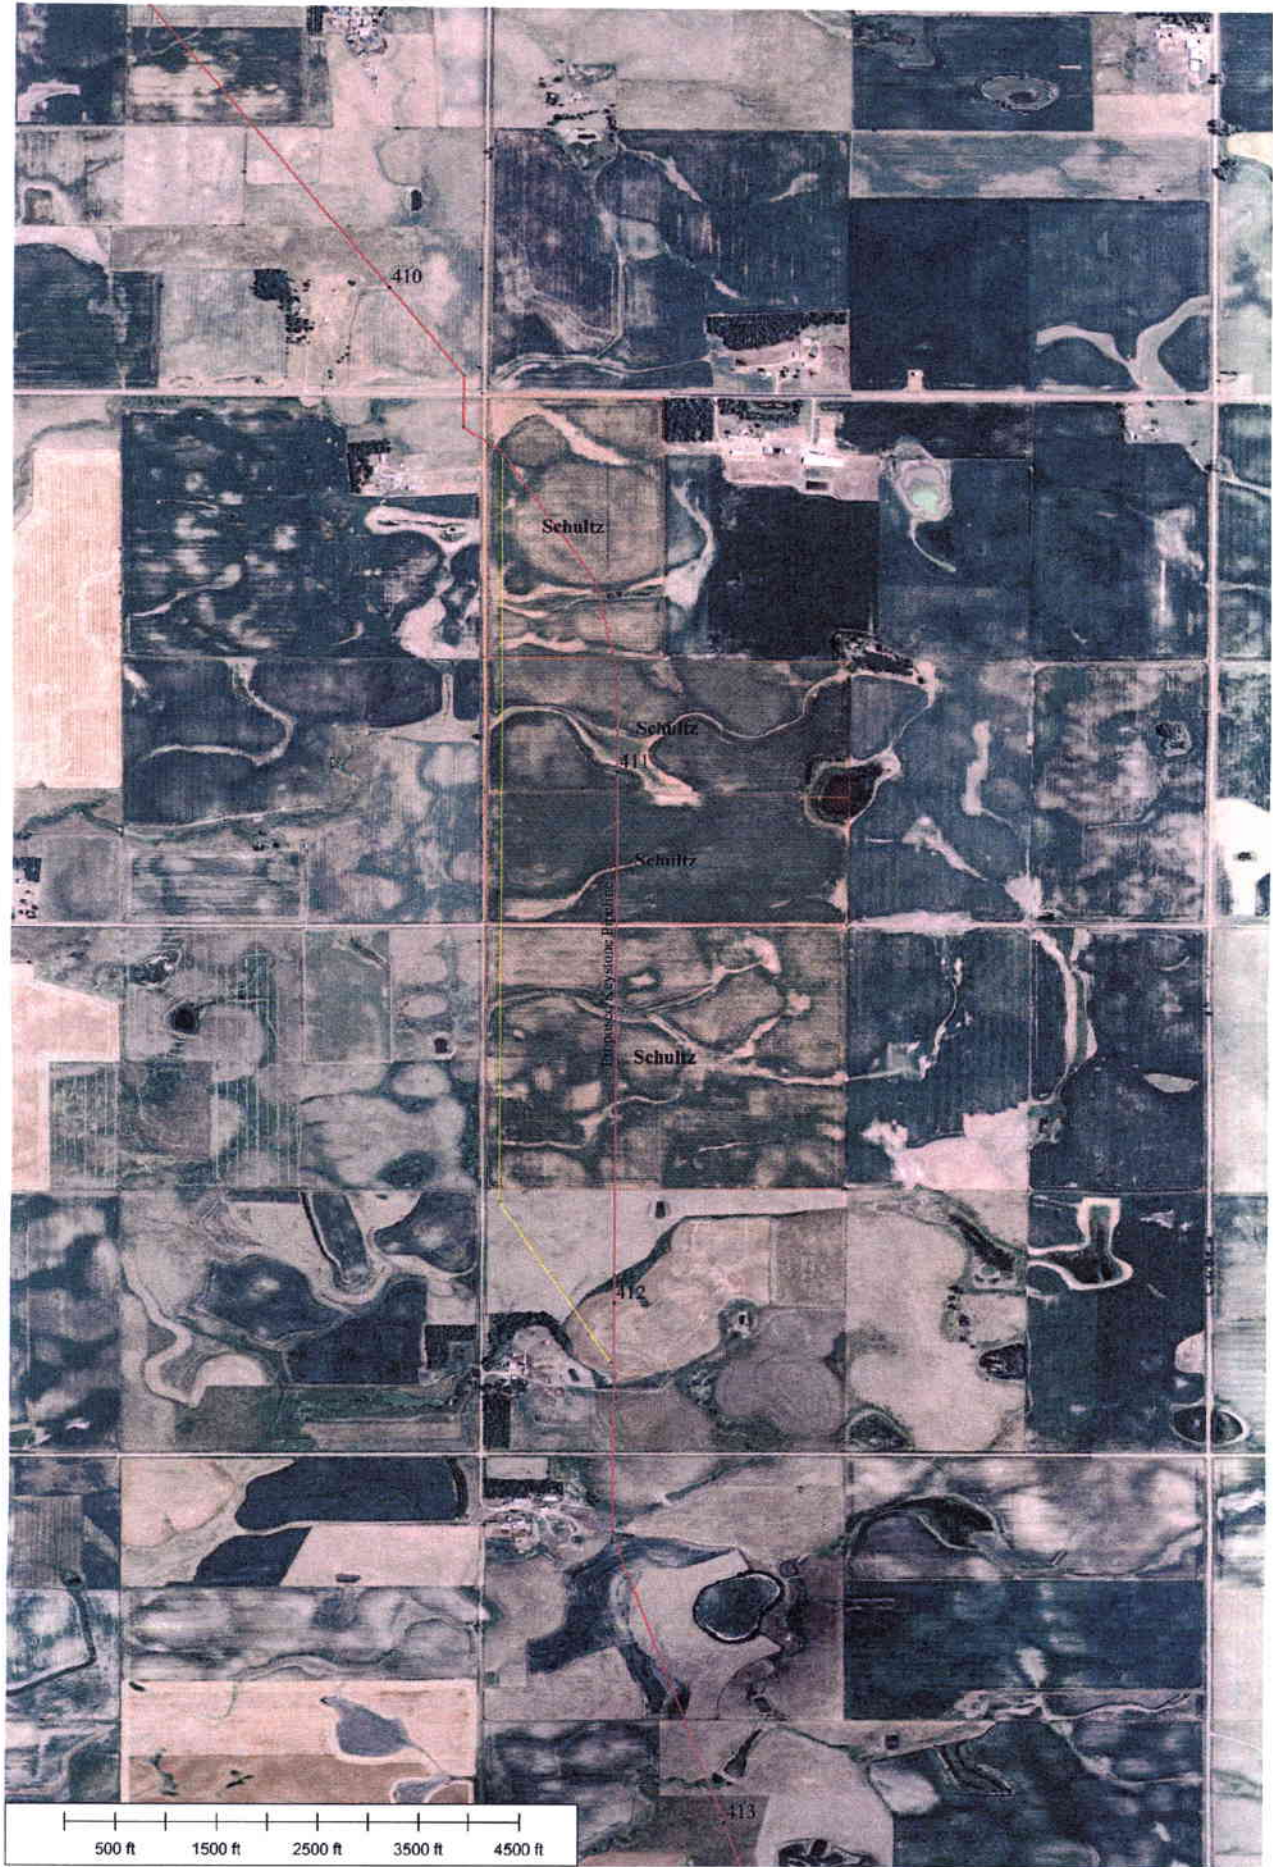


264-SD-410.4-412.1-I

Hutchinson Co. SD Yellow line - reroute Red Line - Original centerline


Reroute MP 427.73 - MP 428.82

255-SD-428.0-428.5-S-rev1

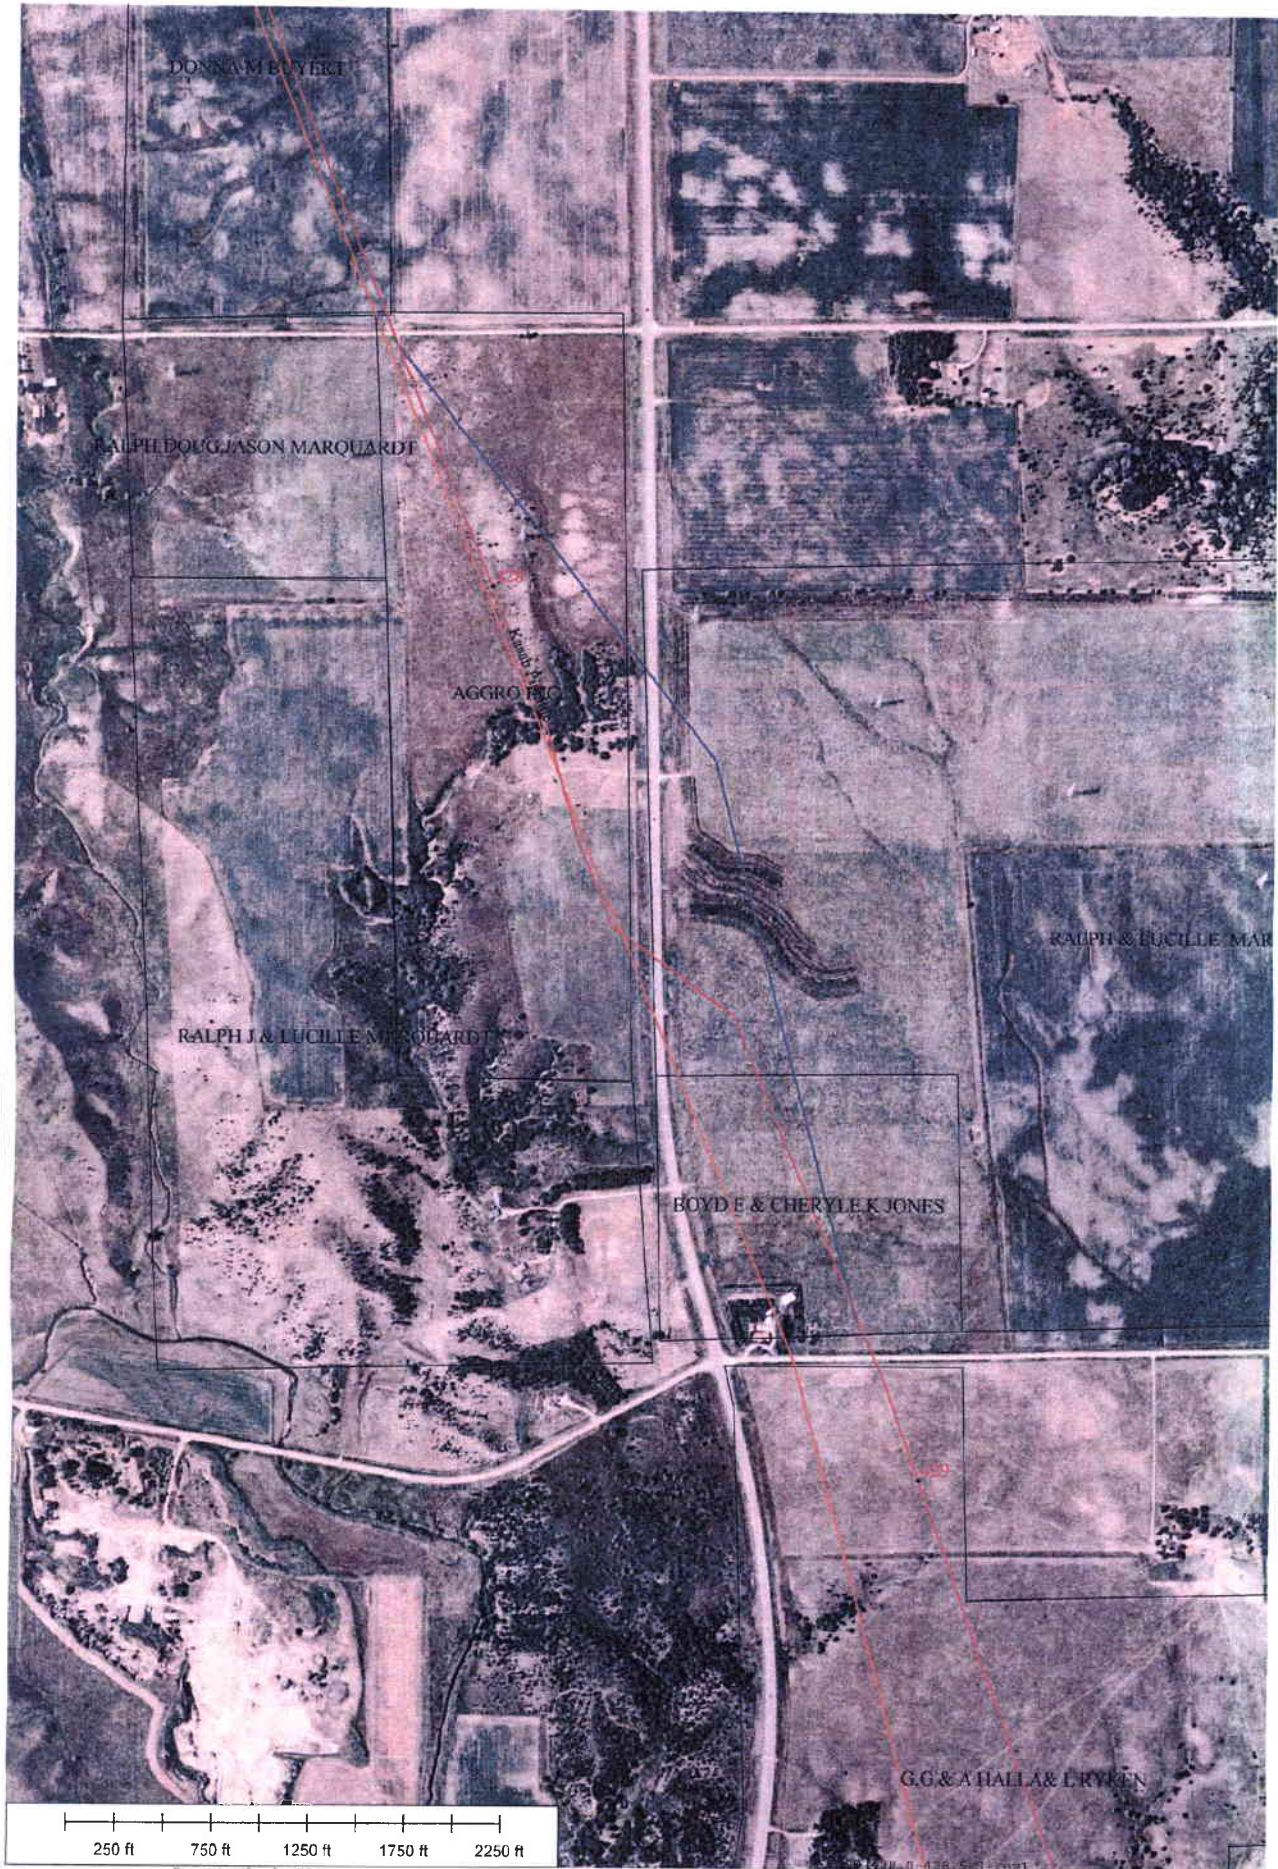

Yankton Co South Dakota

Route Variation 238-SD-430.4-432.5-S-rev1

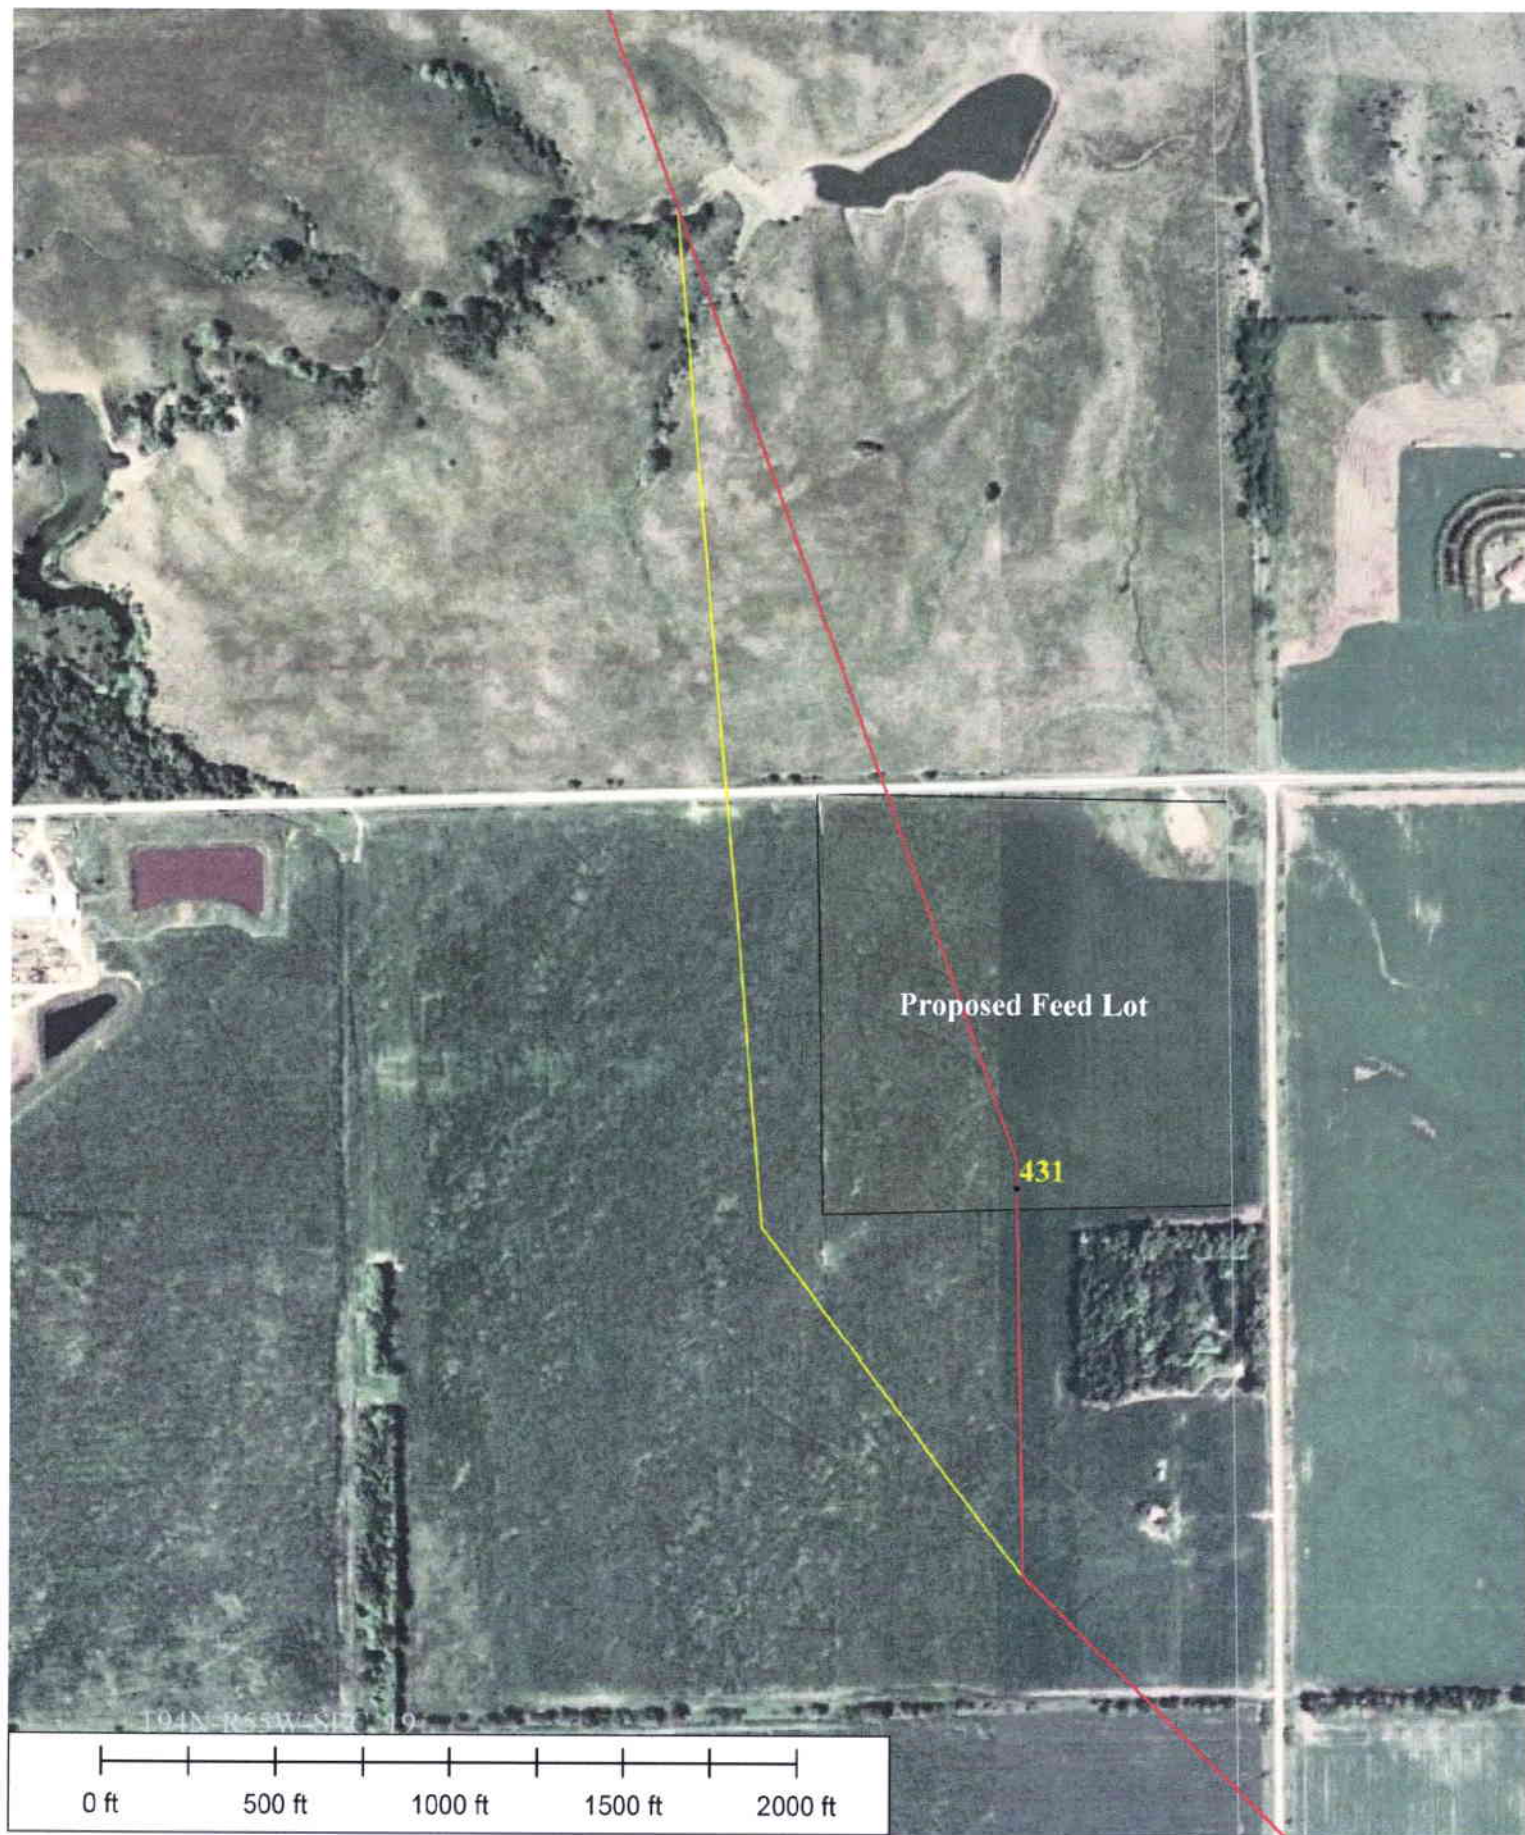

Yankton County, SD

Red Line - Keystone Centerline

Yellow Line - Route Variation

Route Variation 293-SD-434.3-434.6-I




Yankton County, SD

Red Line - Keystone Centerline

Yellow Line - Route Variation

Reroute MP 436.66 - MP 437.24

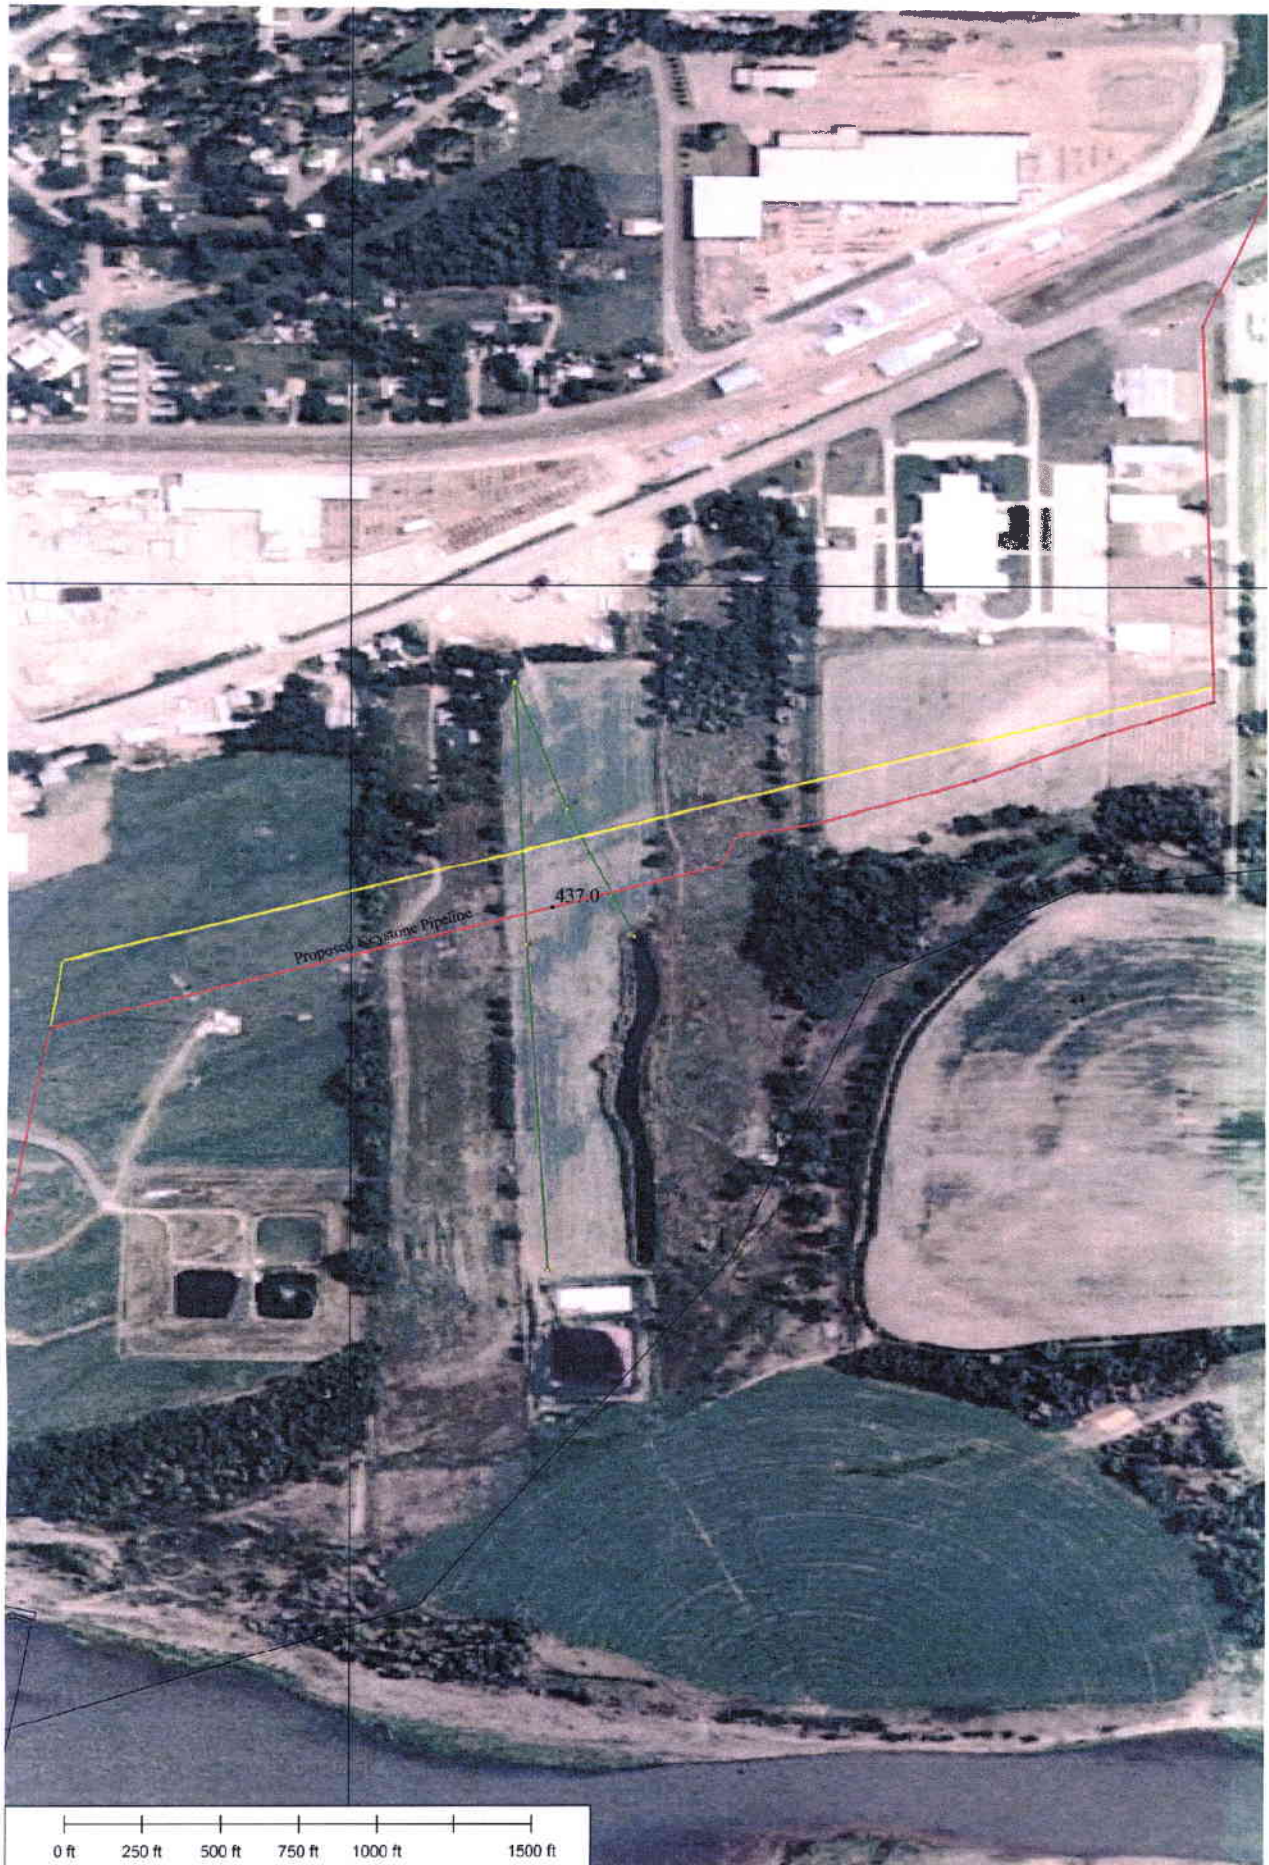

Yankton Co. SD

Red line - Original

Yellow line - Reroute

Green line - Sewer line